


	m2	sq.ft.	%
.00 ACRES) ′ & PARKING) ING) NCES, WALKWAYS, PLANTERS) (SOD/PLANTING) \SURED TO EXTERIOR FACE)	8,113.12 5,277.12 1,025.85 17.12 424.13 1,368.90	87,328.89 56,802.45 11,042.15 184.27 4,565.29 14,734.72	65.04 12.64 0.22 5.23
DING AREA DING AREA	1,368.90 180.00	14,734.72 1,937.50	
Ā:	1,548.90 (No Deduc	16,672.22 tions Taken)	
PER 30m2 - OFFICE USES PER 100m2 - INDUSTRIAL USES	Required 6 14	Actual 24 24	
REQ. COUNT)	1	1	
LS (BASED ON NO AREA DEDUCT	IONS) 20	24	

All I The Upo Rep Doo	Copyright C on Request. production Of cuments In P	pecifications An of The Architect f Drawings, Spo art Or Whole Is	t And Mus <sup>-</sup> ecifications	s And Related
This	s Drawing Is	n Permission. Not To Be Use	d For Con	struction Until
	ned By The A	Architect.		
No	Revision			Date
01  No	Planner / 2	-		June 6, 2019.
				Date
	laim			
•	_	ectu	re	
In	C.			
WOO		, ONTARIO, L	_4L 8E3	
P: (9 F: (9	05) 856-28 05) 856-49	40 12		
		chitecture.c chitecture.c		
Drow	ing Title			
	ing Title ISTING	SITE PLA	٩N	
/ \		<b>.</b>   <b>.</b> /	1	
Proje	ct			
		CASTER		
1201	ϽϢͶϢϙͼϫͼ	ER AVENUE, <sup>-</sup>	[HUbvini	
		Scale	III I U KINHI	
	NOTED	Issued by		N
F.A		File No.		
	7-013	Plot Date		roject North
∠∪1	9-06-06			Project North
01 (	OF 01			SP-1

Contractor Must Check And Verify All Dimensions On The

Job.

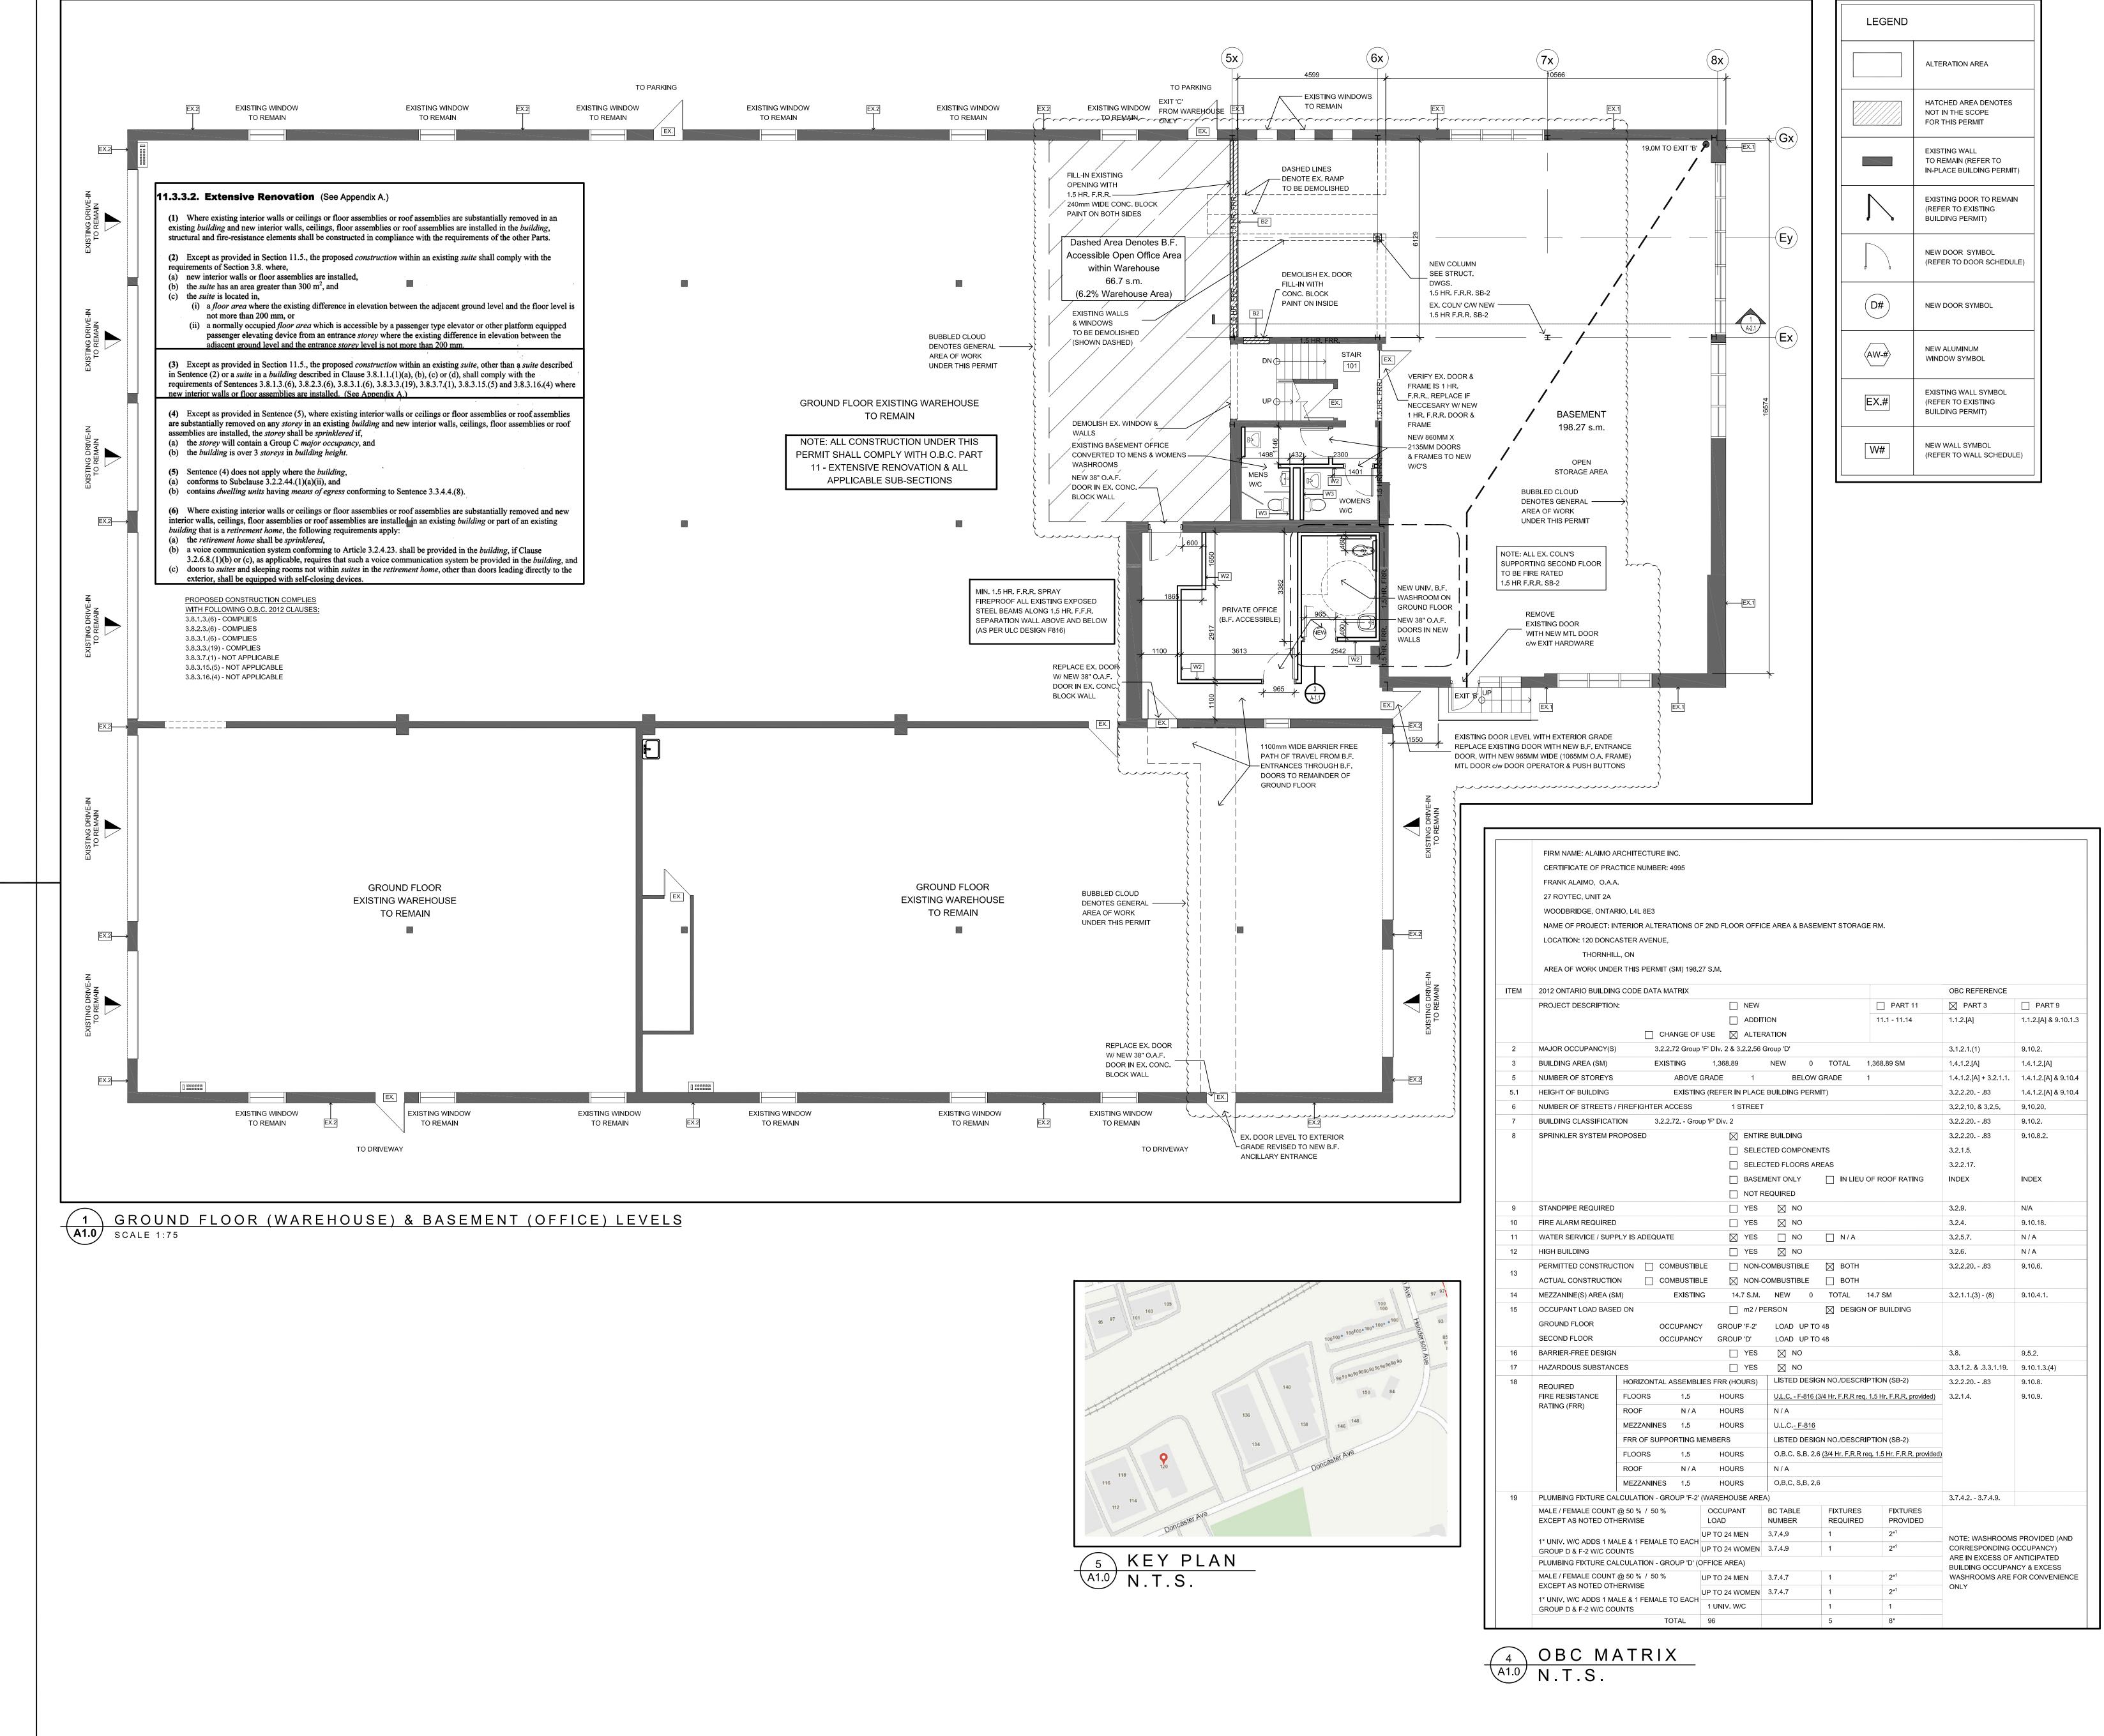


01 OF 05


All I The Upo Rep Doo Arc This	Not Scale The Drawings. Drawings, Specifications And Related copyright Of The Architect And Musion Request. production Of Drawings, Specifications cuments In Part Or Whole Is Forbidde hitects Written Permission. s Drawing Is Not To Be Used For Con ned By The Architect.	t Be Returned s And Related n Without The
No	Revision	Date
1	Amendment to Issued B.P.	Aug. 20, 2018
2	B.P. Resubmission	Nov. 13, 2018
3	B.P. Resubmission	Jan. 4, 2019
4	B.P. Resubmission	Jan. 10, 2019
ON S IT IS THE TO T ANY	E: ERAL CONTRACTOR MUST VERIFY ALL SITE PRIOR TO ANY WORK. THE CONTRACTORS RESPONSIBILITY WORK OF ALL TRADES AND BRING HE ATTENTION OF THE ARCHITECT & E DISCREPANCIES, DEVIATIONS, ETC. AS DISCOVERED.	TO CO-ORDINATE
	FRANCESCO LICENCE 5837 FULCON	9949 15 2 LAIMO JAN 8/2019 15 REEM (7.
07	Building Permit Amendment	Jan. 10, 2019
06	Building Permit Amendment Building Permit Amendment	Jan. 4, 2019
05		Dec. 11, 2018
	Building Permit Amendment	
04	Building Permit Amendment Building Permit Amendment	Nov. 23, 2018. Nov. 13, 2018.
03	Building Permit Amendment	Oct. 24, 2018.
01	Building Permit	Dec. 08, 2017.
No	Issued For	Date
27 R 27 R WOO P: (9 F: (9 info(	laimo rchitecture C. OYTEC, UNIT 2A ODBRIDGE, ONTARIO, L4L 8E3 05) 856-2840 05) 856-4912 @alaimoarchitecture.com v.alaimoarchitecture.com	
2N	D FLOOR & SEMENT FLOOR PLA	ANS
INT	ERIOR ALTERATION	IS
	DONCASTER AVENUE, THORNHI NOTED Drawn by	LL, ON
F.A	Checked by	True North
201	File No. 7-013 9-01-10	Project North
01(	OF 05	A1.0

Contractor Must Check And Verify All Dimensions On The


Job.

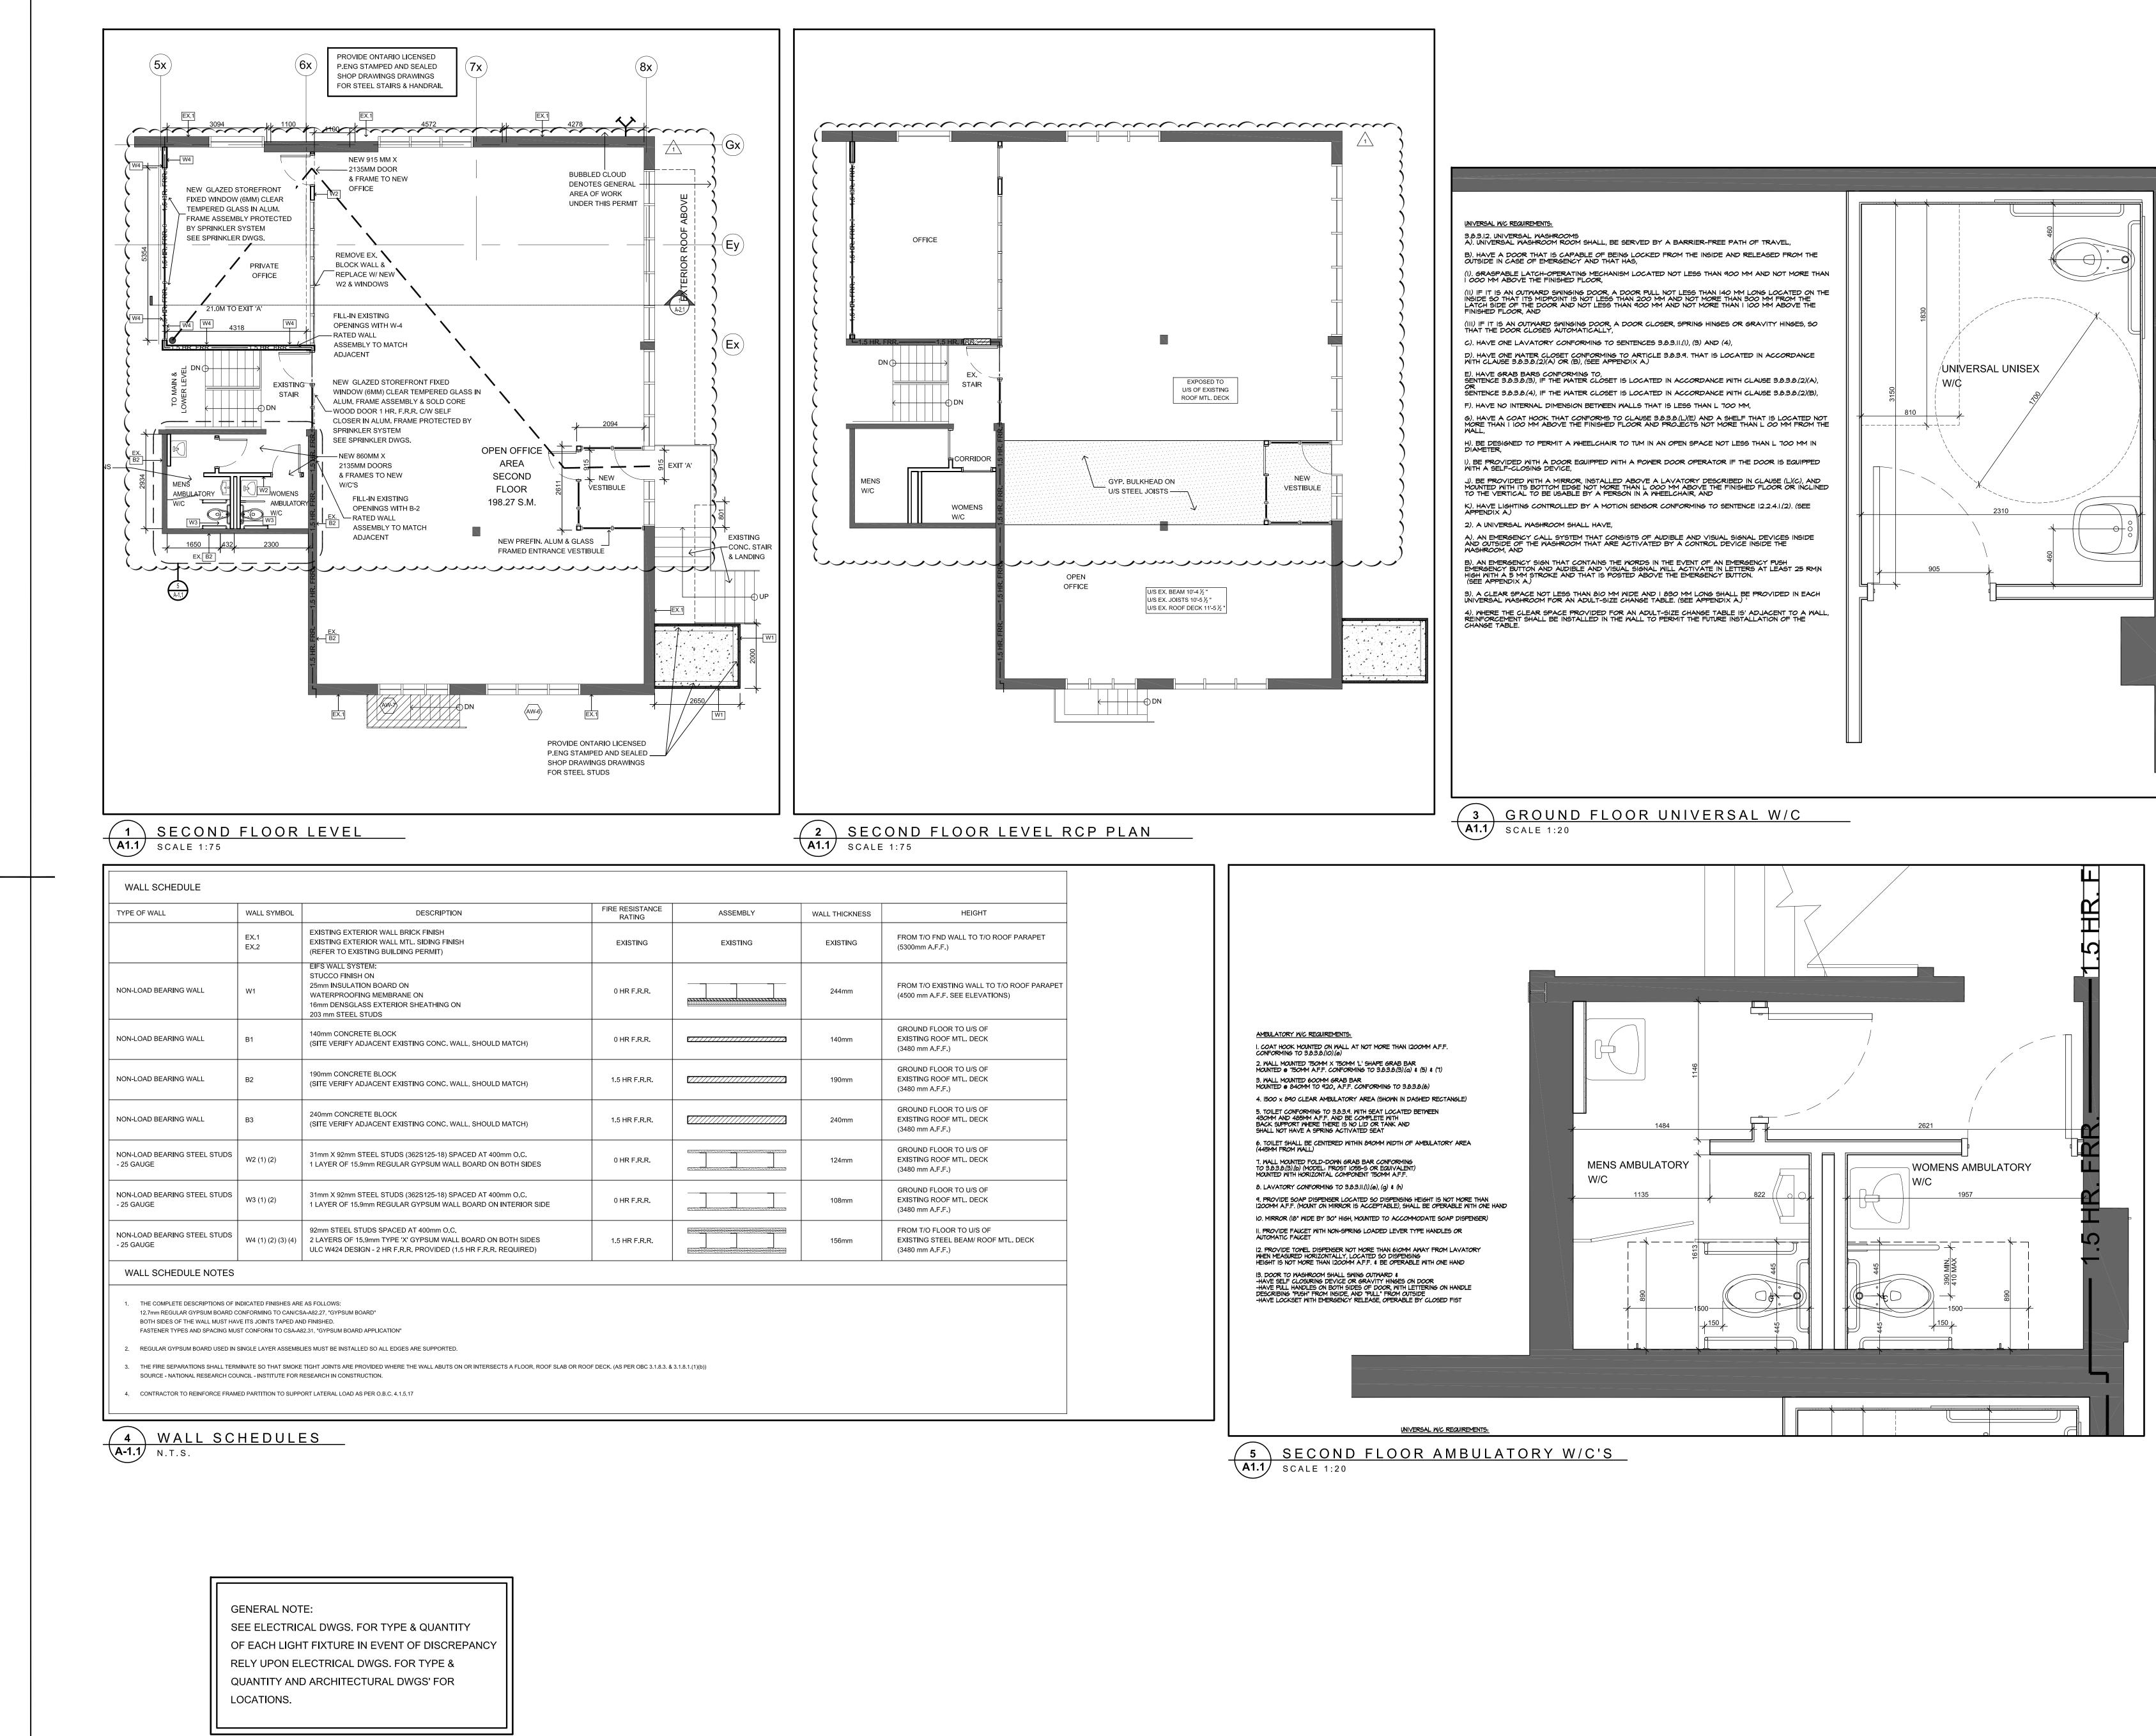

ON SITE PRIOR TO ANY WORK. IT IS THE CONTRACTORS RESPONSIBILITY TO CO-ORDINATE THE WORK OF ALL TRADES AND BRING TO THE ATTENTION OF THE ARCHITECT & ENGINEERS ANY DISCREPANCIES, DEVIATIONS, ETC. AS SOON AS THEY ARE DISCOVERED.

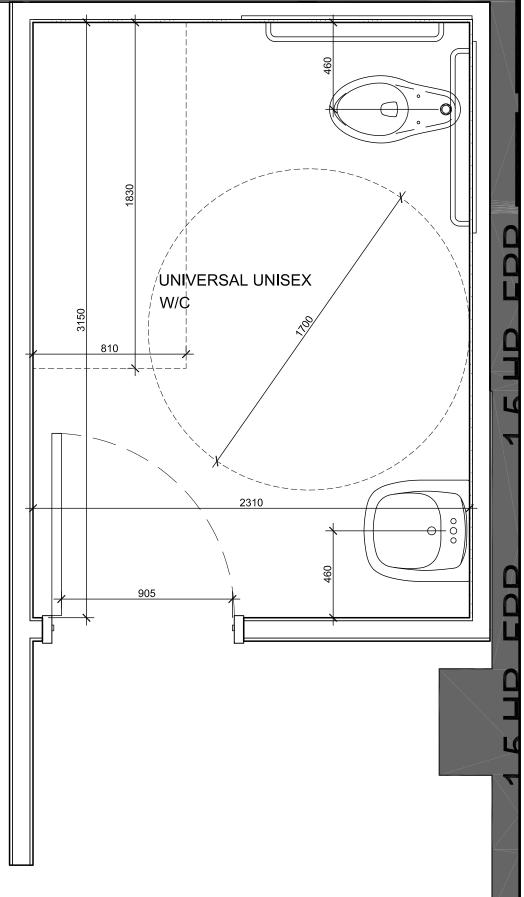

Contractor Must Check And Verify All Dimensions On The Job.				
Do l	Not Scale The Drawings.			
All Drawings, Specifications And Related Documents Are The Copyright Of The Architect And Must Be Returned Upon Request.				
Reproduction Of Drawings, Specifications And Related Documents In Part Or Whole Is Forbidden Without The Architects Written Permission.				
This Drawing Is Not To Be Used For Construction Until Signed By The Architect.				
lo	Revision	Date		
	Amendment to Issued B.P.	Aug. 20, 2018		
	B.P. Resubmission	Nov. 13, 2018		
1	B.P. Resubmission	Jan. 4, 2019		
	B.P. Resubmission	Jan. 10, 2019		
NOTE GENE	E: ERAL CONTRACTOR MUST VERIFY ALL	DIMENSIONS		

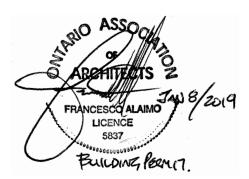

07	Building Permit Amendment	Jan. 10, 2019
06	Building Permit Amendment	Jan. 4, 2019
05	Building Permit Amendment	Dec. 11, 2018
04	Building Permit Amendment	Nov. 23, 2018.
03	Building Permit Amendment	Nov. 13, 2018.
02	Building Permit Amendment	Oct. 24, 2018.
01	Building Permit	Dec. 08, 2017.
10	Issued For	Date

#### alaimo architecture INC.

27 ROYTEC, UNIT 2A WOODBRIDGE, ONTARIO, L4L 8E3 P: (905) 856-2840 F: (905) 856-4912 info@alaimoarchitecture.com www.alaimoarchitecture.com

Drawing Title

2ND FLOOR PLAN & WALL TYPE SCHEDULE


Project INTERIOR ALTERATIONS

120 DONCASTER AVENUE, THORNHILL, ON Scale AS NOTED Drawn by T.A. Checked by F.A.

File No. 2017-013 Plot Date 2019-01-10


A1.1

02 OF 05

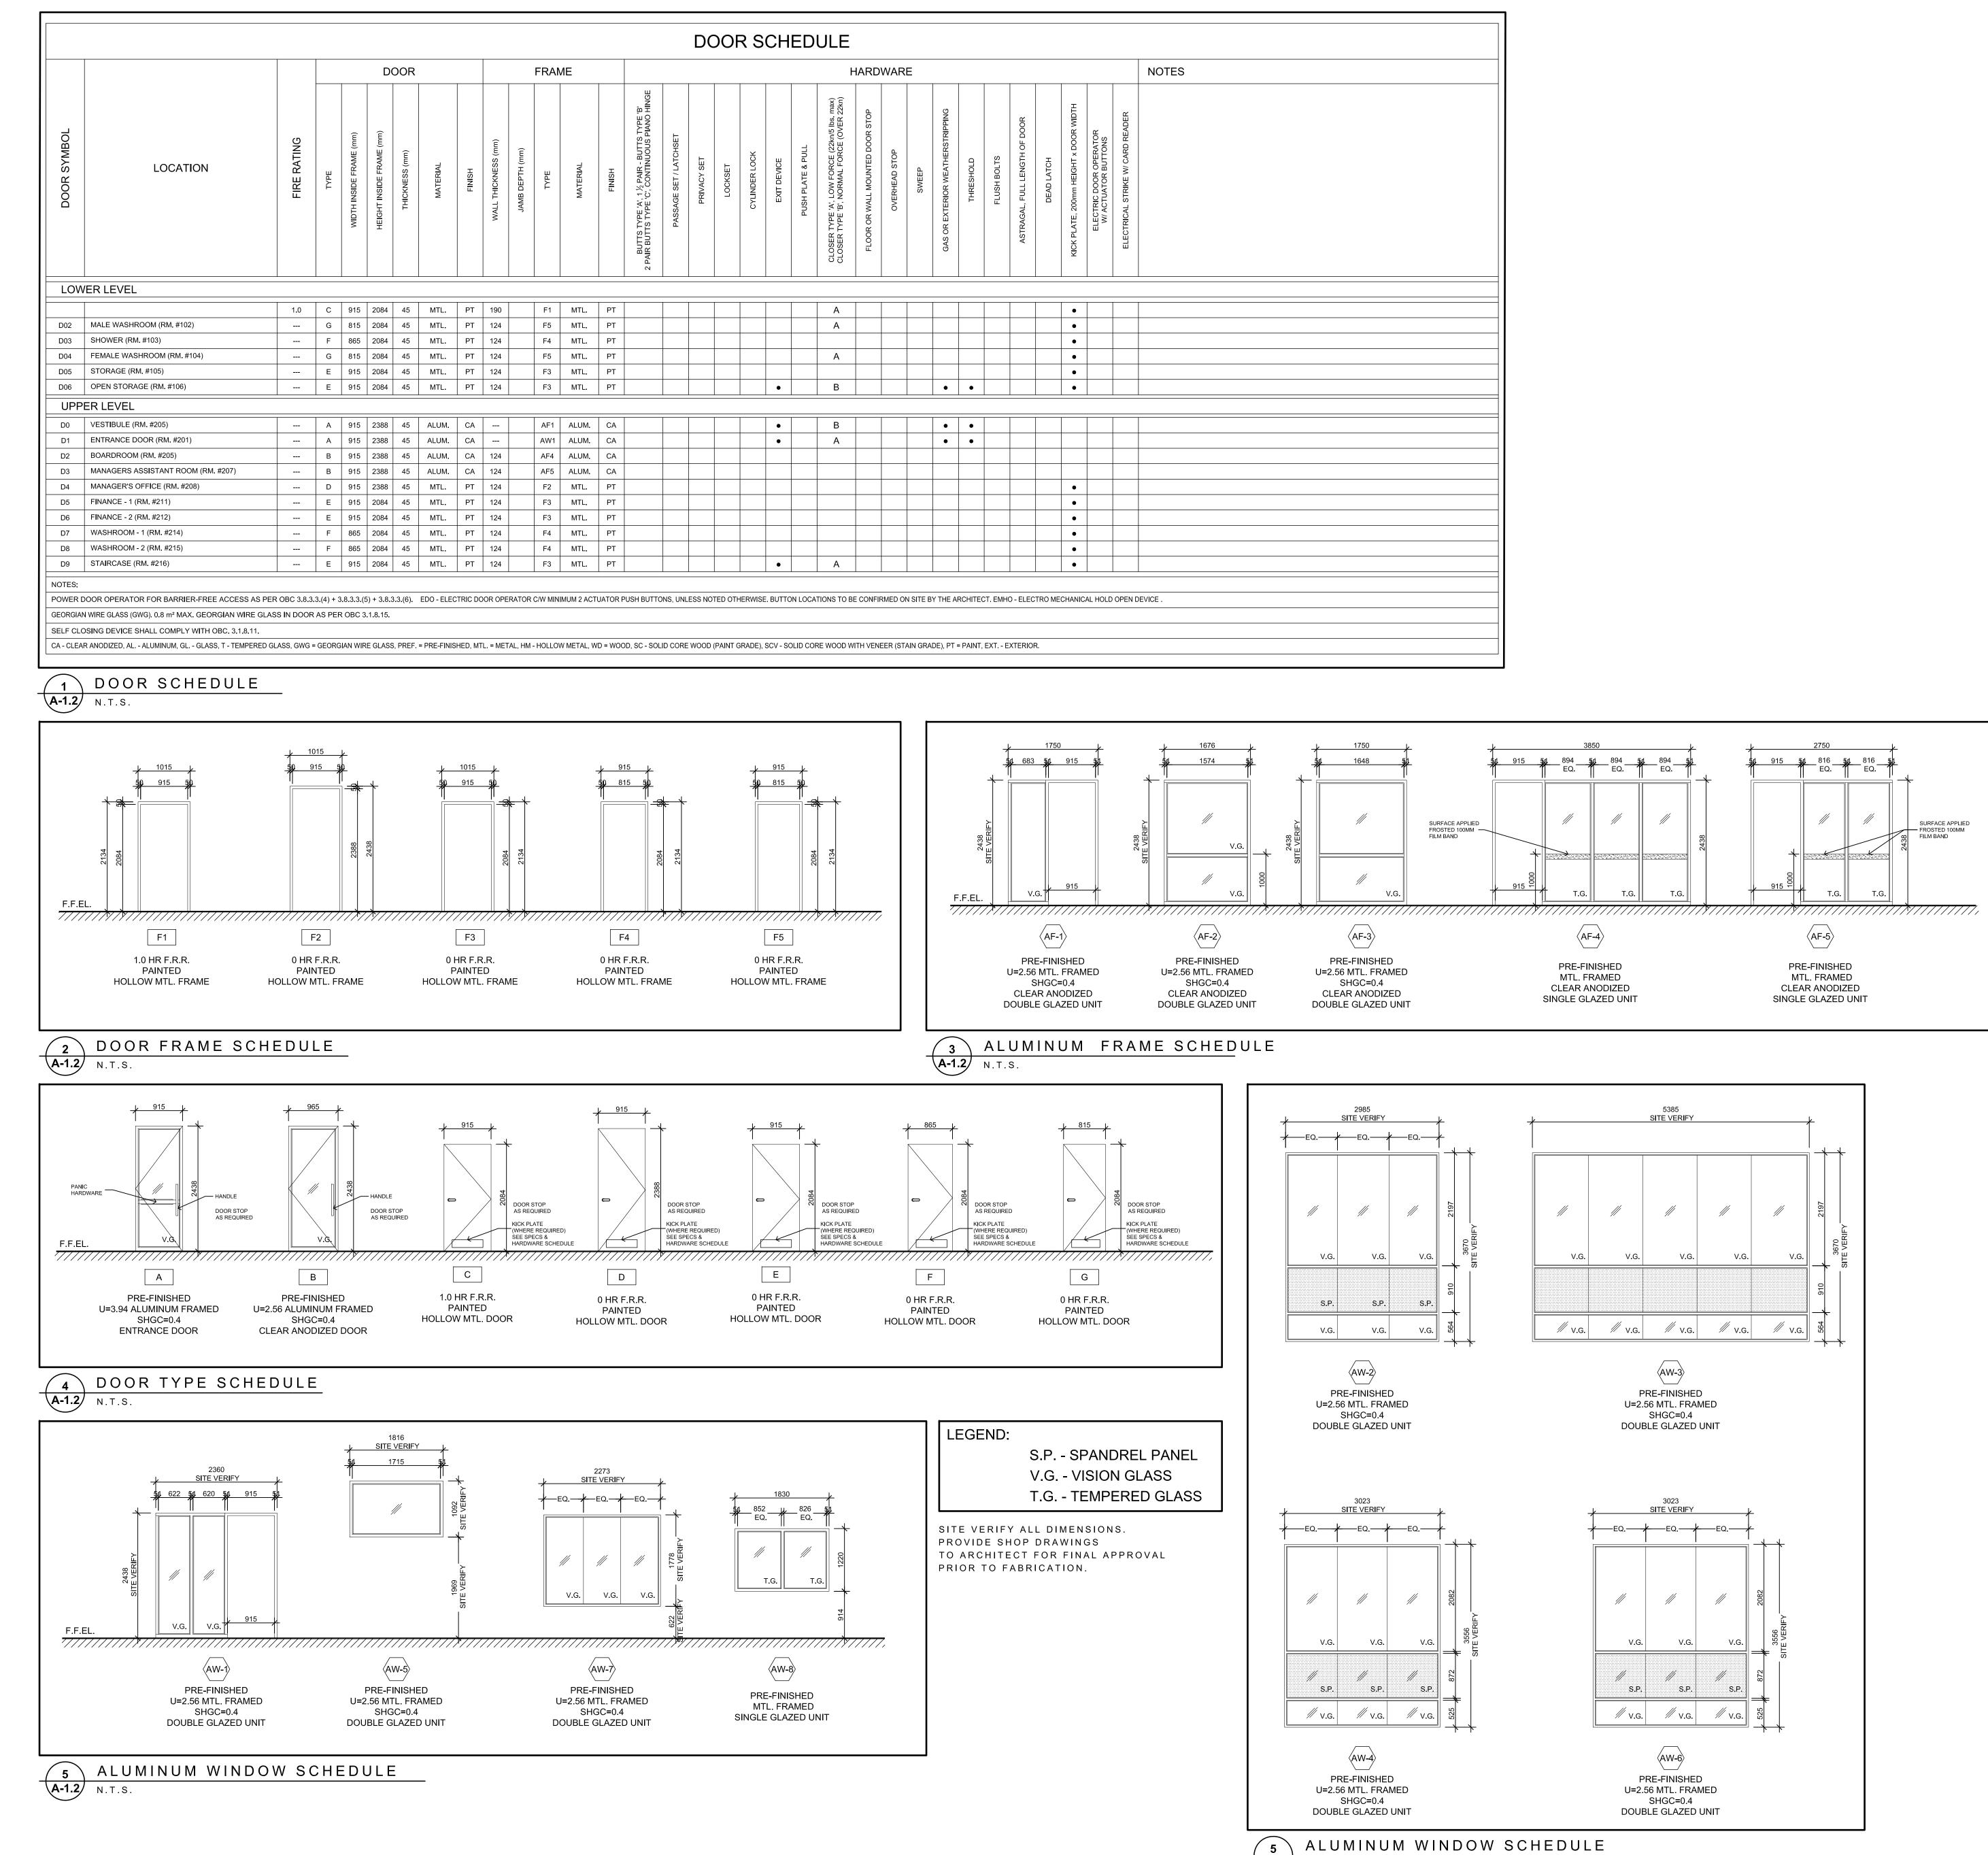

A-1.2 N.T.S.

Job		nensions On The
All	Not Scale The Drawings. Drawings, Specifications And Related Copyright Of The Architect And Musi	
Upo Rep	on Request. production Of Drawings, Specifications	s And Related
Arc	cuments In Part Or Whole Is Forbidde hitects Written Permission.	
	s Drawing Is Not To Be Used For Con ned By The Architect.	
No	Revision	Date
1	B.P. Resubmission	Nov. 13, 2018
	1	
ΝΟΤΙ		
GEN	 ERAL CONTRACTOR MUST VERIFY ALL SITE PRIOR TO ANY WORK.	DIMENSIONS
	THE CONTRACTORS RESPONSIBILITY WORK OF ALL TRADES AND BRING	TO CO-ORDINATE
	HE ATTENTION OF THE ARCHITECT & E DISCREPANCIES, DEVIATIONS, ETC. AS	
ARE	DISCOVERED.	
		Deul
	APPIO AS	
		TS Z
	X EDANOFOCOL	JAN 8/2019
	FRANCESCO LICENCI 5837	
		in the second seco
		in the second seco
02	LICENCE S837 BUILDIN	g Reemon.
02	Building Permit Amendment	ς βεεπιτ. Nov. 13, 2018.
02 01 No	LICENCE S837 BUILDIN	g Reemon.
01 No	Building Permit Amendment Building Permit Issued For	<i>c</i> , <i>Ree</i> πιτ. Nov. 13, 2018. Oct. 24, 2017.
01 No	Building Permit Amendment Building Permit Issued For	<i>c</i> , <i>Ree</i> πιτ. Nov. 13, 2018. Oct. 24, 2017.
01 No C	Building Permit Amendment Building Permit Issued For Iaimo rchitecture	<i>c</i> , <i>Ree</i> πιτ. Nov. 13, 2018. Oct. 24, 2017.
<sup>01</sup> No A	Building Permit Amendment Building Permit Issued For Iaimo chitecture C.	<i>c</i> , <i>Ree</i> πιτ. Nov. 13, 2018. Oct. 24, 2017.
01 No a in	Building Permit Amendment Building Permit Issued For Iaimo rchitecture	<i>c</i> , <i>Ree</i> πιτ. Nov. 13, 2018. Oct. 24, 2017.
01 No <b>a</b> in 27 R WO P: (9 F: (9	Building Permit Amendment Building Permit Building Permit Issued For Issued For Issued For OYTEC, UNIT 2A ODBRIDGE, ONTARIO, L4L 8E3 05) 856-2840 05) 856-4912	<i>c</i> , <i>Ree</i> πιτ. Nov. 13, 2018. Oct. 24, 2017.
01 No <b>O</b> <b>O</b> <b>O</b> <b>O</b> <b>O</b> <b>O</b> <b>O</b> <b>O</b> <b>O</b> <b>O</b>	Building Permit Amendment Building Permit Building Permit Issued For Iaimo chitecture C. OYTEC, UNIT 2A ODBRIDGE, ONTARIO, L4L 8E3 05) 856-2840	<i>c</i> , <i>Ree</i> πιτ. Nov. 13, 2018. Oct. 24, 2017.
01 No O O I O P: (9 F: (9 F: (9 N) O O P: (9 F: (9 N) O O O O O O O O O O O O O O O O O O	Building Permit Amendment Building Permit Amendment Building Permit Issued For Issued For OYTEC, UNIT 2A ODBRIDGE, ONTARIO, L4L 8E3 05) 856-2840 05) 856-2840 05) 856-4912	<i>c</i> , <i>Ree</i> πιτ. Nov. 13, 2018. Oct. 24, 2017.
01 No <b>O</b> <b>O</b> <b>O</b> <b>O</b> <b>O</b> <b>O</b> <b>O</b> <b>O</b> <b>O</b> <b>O</b>	Building Permit Amendment Building Permit Issued For Issued For Issued For OYTEC, UNIT 2A ODBRIDGE, ONTARIO, L4L 8E3 05) 856-2840 05) 856-2840 05) 856-4912 Qalaimoarchitecture.com	<i>c</i> , <i>Ree</i> πιτ. Nov. 13, 2018. Oct. 24, 2017.
01 No O C C C C C C C C C C C C C C C C C C	Building Permit Amendment Building Permit Amendment Building Permit Issued For Issued For Issued For OYTEC, UNIT 2A ODBRIDGE, ONTARIO, L4L 8E3 05) 856-2840 05) 856-2840 05) 856-4912 @alaimoarchitecture.com	Reenco.
01 No O C C C C C C C C C C C C C C C C C C	Building Permit Amendment Building Permit Issued For Issued For Issued For OYTEC, UNIT 2A ODBRIDGE, ONTARIO, L4L 8E3 ODBRIDGE, ONTARIO, L4L 8E3 OS) 856-2840 OS) 856-2840 OS) 856-4912 Qalaimoarchitecture.com	Reenco.
01 No O O O P: (9 F: (9 F: (9 F: (9 F: (9 F: (9 O O D raw D C W O D raw	Building Permit Amendment Building Permit Issued For Iaimo chitecture C. OYTEC, UNIT 2A DDBRIDGE, ONTARIO, L4L 8E3 ODBRIDGE, ONTARIO, L4L 8E3 OS) 856-2840 OS) 856-2840 OS) 856-4912 @alaimoarchitecture.com v.alaimoarchitecture.com	Reenca.
01 No O O O P: (9 F: (9 F: (9 F: (9 F: (9 F: (9 O O D raw D C W O D raw	Building Permit Amendment Building Permit Issued For Iaimo chitecture C. OYTEC, UNIT 2A ODBRIDGE, ONTARIO, L4L 8E3 05) 856-2840 05) 856-4912 @alaimoarchitecture.com v.alaimoarchitecture.com	Reenca.
01 No O O O P: (9 F: (9 F: (9 F: (9 F: (9 F: (9 O O D raw D C W O D raw	Building Permit Amendment Building Permit Issued For Iaimo chitecture C. OYTEC, UNIT 2A DDBRIDGE, ONTARIO, L4L 8E3 ODBRIDGE, ONTARIO, L4L 8E3 OS) 856-2840 OS) 856-2840 OS) 856-4912 @alaimoarchitecture.com v.alaimoarchitecture.com	Reenca.
01 No O C C C C C C C C C C C C C C C C C C	Building Permit Amendment Building Permit Issued For Iaimo chitecture C. OYTEC, UNIT 2A DDBRIDGE, ONTARIO, L4L 8E3 ODBRIDGE, ONTARIO, L4L 8E3 OS) 856-2840 OS) 856-2840 OS) 856-4912 @alaimoarchitecture.com v.alaimoarchitecture.com	Rean(T. Nov. 13, 2018. Oct. 24, 2017. Date
01 No <b>C</b> 27 R VO P: (9 F: (9 F: (9 F: (9 F: (9 F: (9 Draw Draw Draw Draw Draw	Building Permit Amendment Building Permit Issued For Idimo chitecture C. OYTEC, UNIT 2A ODBRIDGE, ONTARIO, L4L 8E3 ODBRIDGE, ONTARIO, L4L 8E3 ODBRIDGE, ONTARIO, L4L 8E3 OS) 856-2840 OS) 856-2840 OS) 856-2840 OS) 856-4912 @alaimoarchitecture.com v.alaimoarchitecture.com v.alaimoarchitecture.com trat DOR SCHEDULES NDOW SCHEDULES NDOW SCHEDULES	Rean(T. Nov. 13, 2018. Oct. 24, 2017. Date
01 No O C C C C C C C C C C C C C C C C C C	Building Permit Amendment Building Permit Issued For Iaimo chitecture C. OYTEC, UNIT 2A ODBRIDGE, ONTARIO, L4L 8E3 05) 856-2840 05) 856-2840 050 856-2840 050 856-2840 050 856-2840 100 856	Rean(T. Nov. 13, 2018. Oct. 24, 2017. Date
01 No O O O O O O O O O O O O O O O O O O	Building Permit Amendment Building Permit Amendment Building Permit Issued For Iaimo C. OYTEC, UNIT 2A ODBRIDGE, ONTARIO, L4L 8E3 O5) 856-2840 O5) 856-2840 O5) 856-4912 @alaimoarchitecture.com v.alaimoarchitecture.com ing Title DOR SCHEDULES NDOW SCHEDULES NDOW SCHEDULES CHERIOR ALTERATION DONCASTER AVENUE, THORNHI NOTED Checked by Checked by	Reanca.
01 No O O O O P C O C O C O C O C O C O C O C	Building Permit Amendment Building Permit Issued For Iaimo Chitecture C. OYTEC, UNIT 2A ODBRIDGE, ONTARIO, L4L 8E3 05) 856-2840 05) 856-2840 05) 856-2840 05) 856-4912 adaimoarchitecture.com ing Title DOR SCHEDULES NDOW SCHEDULES NDOW SCHEDULES CONCASTER AVENUE, THORNHI NOTED Checked by	Reeven.
01 No O O O O O O O O O O O O O O O O O O	Building Permit Amendment Building Permit Issued For Idimo chitecture C. OYTEC, UNIT 2A DDBRIDGE, ONTARIO, L4L 8E3 05) 856-2840 05) 856-2840 050 856	Reanca.
01 No O O O O O O O O O O O O O O O O O O	Building Permit Amendment Building Permit Amendment Issued For Iaimo chitecture C. OYTEC, UNIT 2A DDBRIDGE, ONTARIO, L4L 8E3 05) 856-2840 05) 856-2840 050 856-28	Reence. Reence. Nov. 13, 2018. Oct. 24, 2017. Date
01 No O O O O O O O O O O O O O O O O O O	Building Permit Amendment Building Permit Issued For Idimo chitecture C. OYTEC, UNIT 2A DDBRIDGE, ONTARIO, L4L 8E3 05) 856-2840 05) 856-2840 050 856	Reeven.

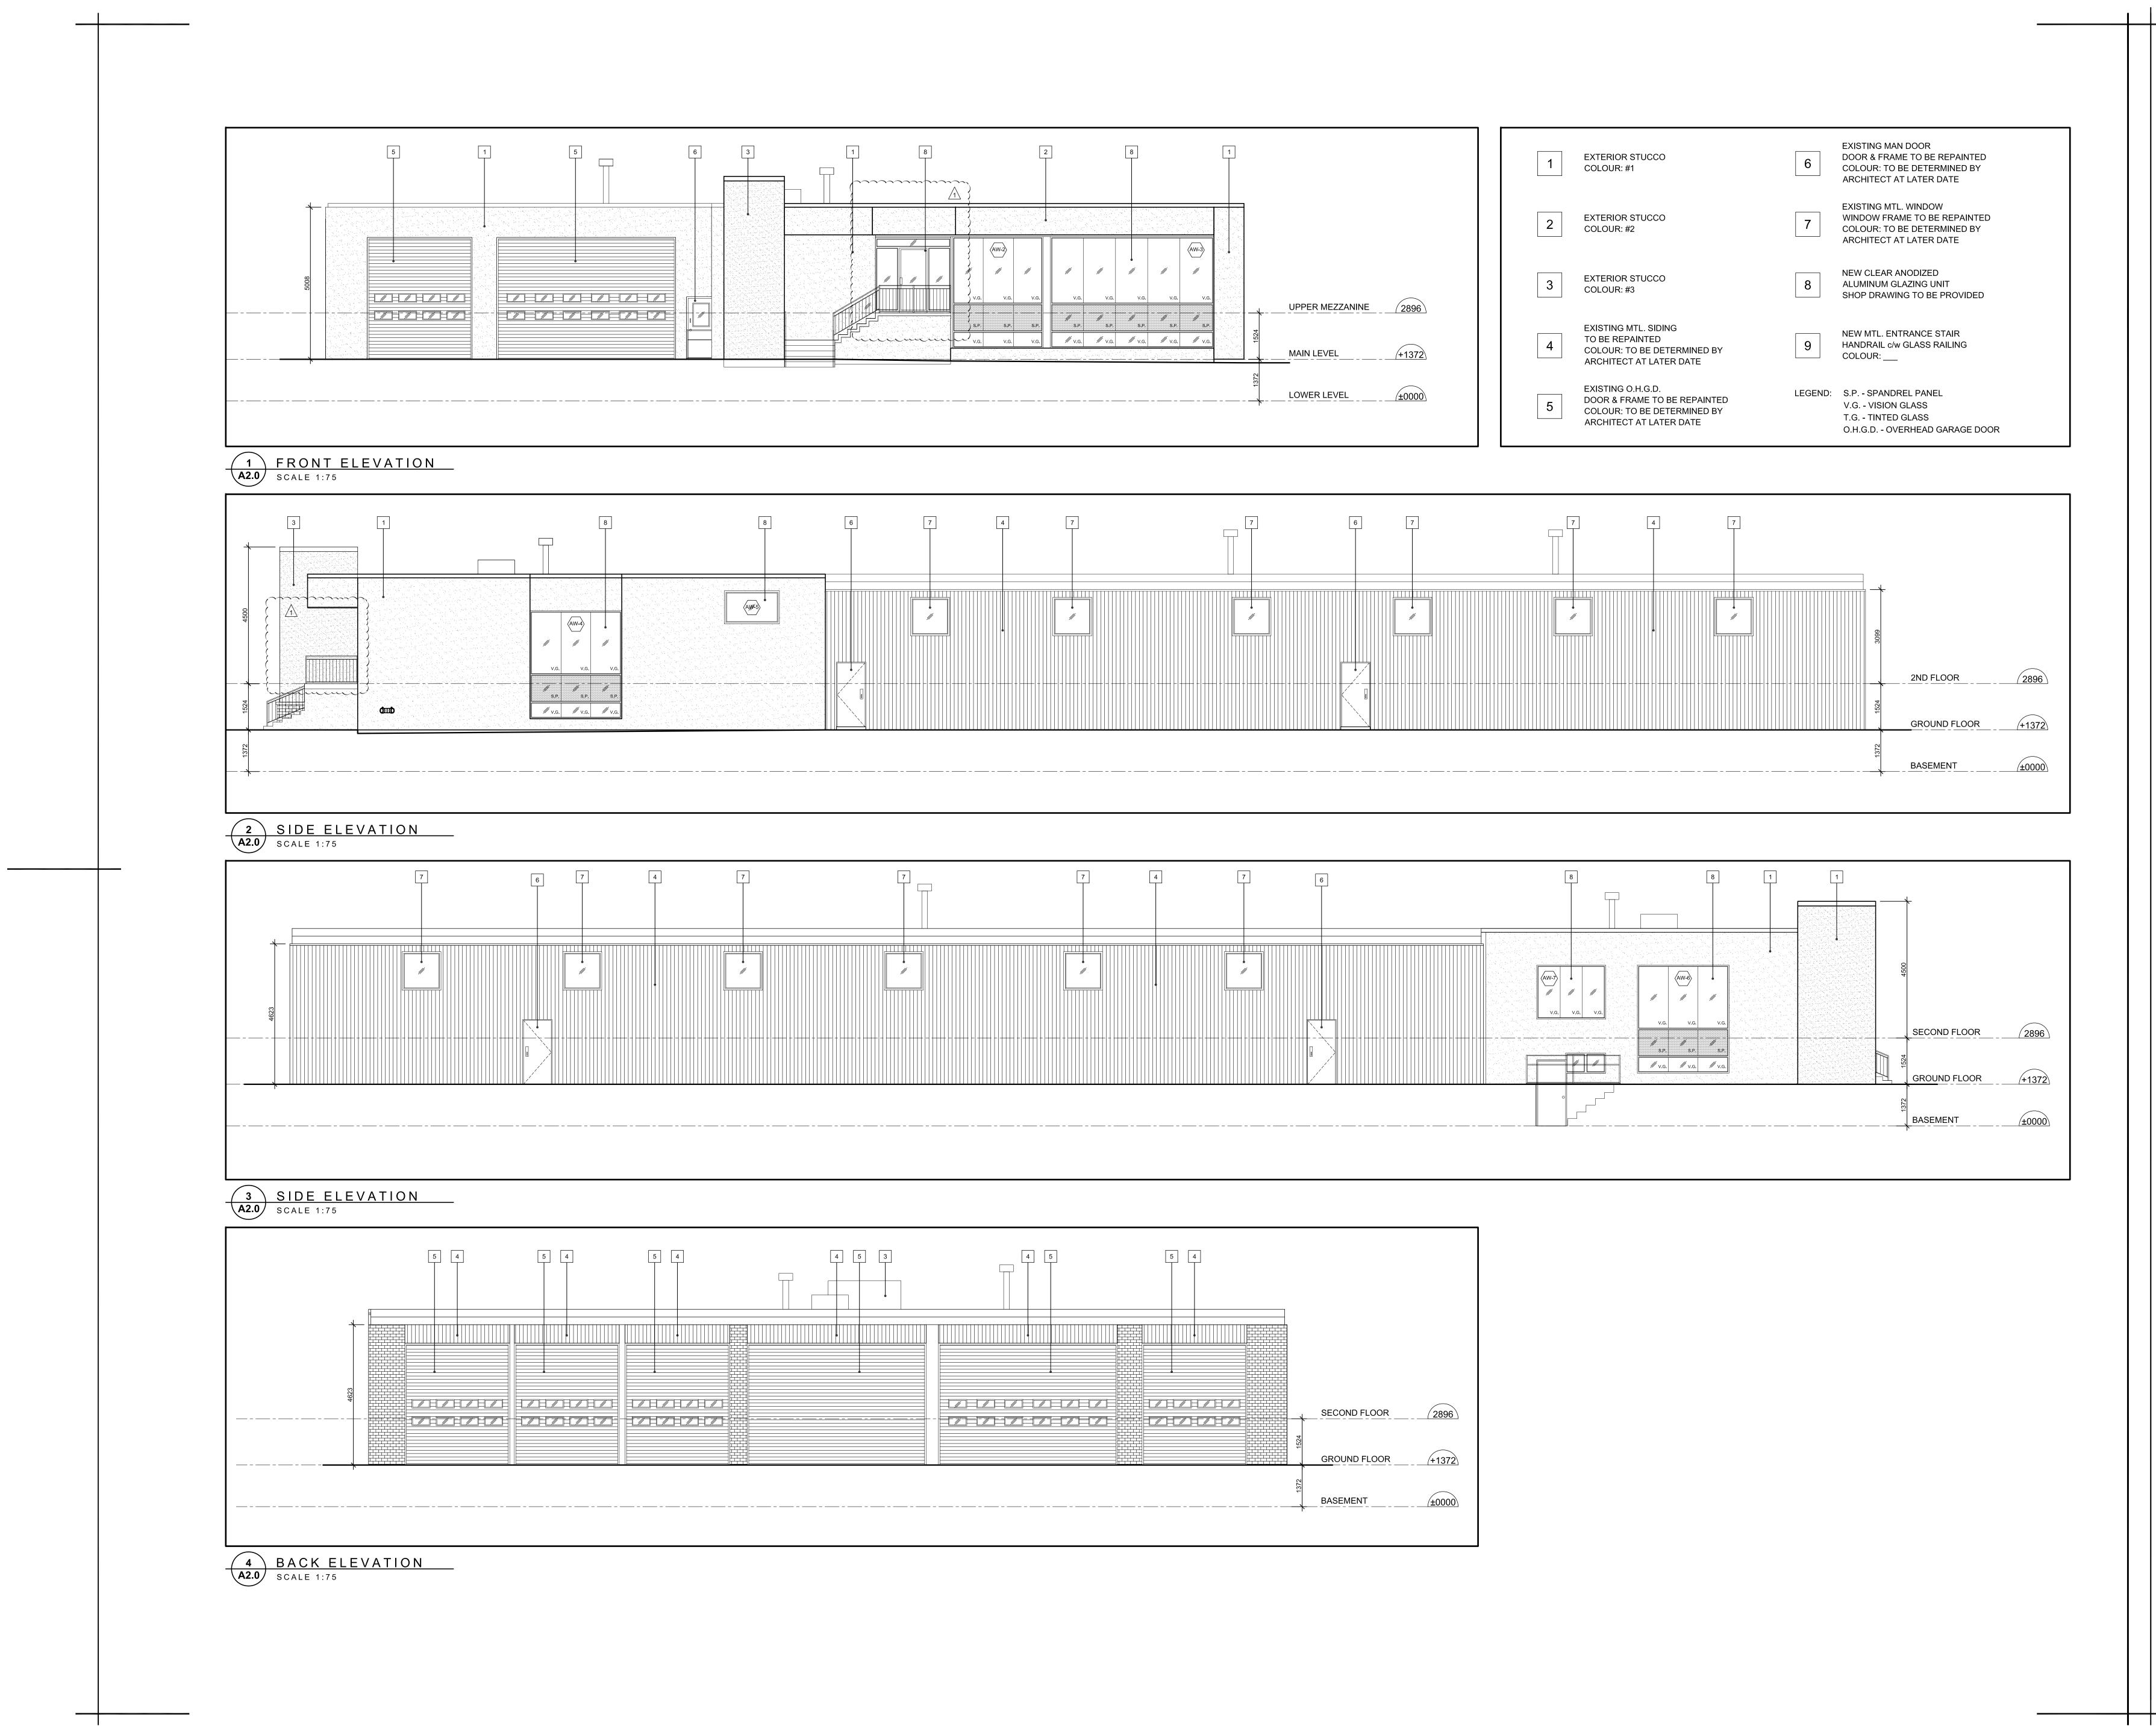

alaimo architecture inc. 27 ROYTEC, UNIT 2A WOODBRIDGE, ONTARIO, L4L 8E3

Job.

Do Not Scale The Drawings.

04 OF 05 A2.0
2019-01-16 Plot Date
File No. 2017-013
Checked by F.A.
Drawn by T.A.
AS NOTED Scale
120 DONCASTER AVENUE, THORNHILL, ON
INTERIOR ALTERATIONS
ELEVATIONS
Drawing Title
info@alaimoarchitecture.com www.alaimoarchitecture.com
WOODBRIDGE, ONTARIO, L4L 8E3 P: (905) 856-2840 F: (905) 856-4912


03 Building Permit Amendment Jan. 16, 2019 02 Building Permit Amendment Nov. 13, 2018. 01 Building Permit No Issued For


Dec. 08, 2017. Date

NOTE: GENERAL CONTRACTOR MUST VERIFY ALL DIMENSIONS ON SITE PRIOR TO ANY WORK. IT IS THE CONTRACTORS RESPONSIBILITY TO CO-ORDINATE THE WORK OF ALL TRADES AND BRING TO THE ATTENTION OF THE ARCHITECT & ENGINEERS ANY DISCREPANCIES, DEVIATIONS, ETC. AS SOON AS THEY ARE DISCOVERED.

The	Drawings, Specifications And Related Copyright Of The Architect And Must on Request.	
Doo	production Of Drawings, Specifications cuments In Part Or Whole Is Forbidder hitects Written Permission.	א And Related Without The
	s Drawing Is Not To Be Used For Con ned By The Architect.	struction Until
No	Revision	Date
01	Revised Front Entrance	Jan. 16, 2019

Contractor Must Check And Verify All Dimensions On The

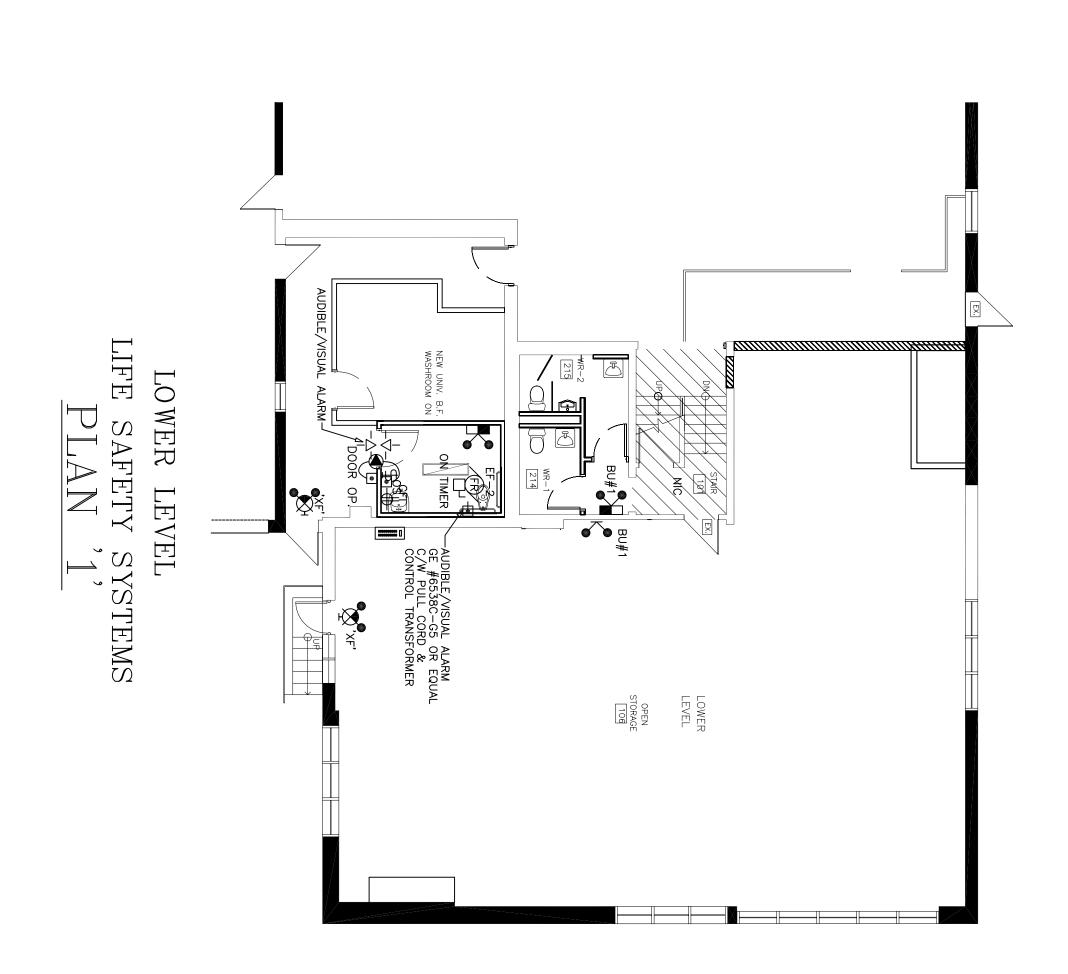

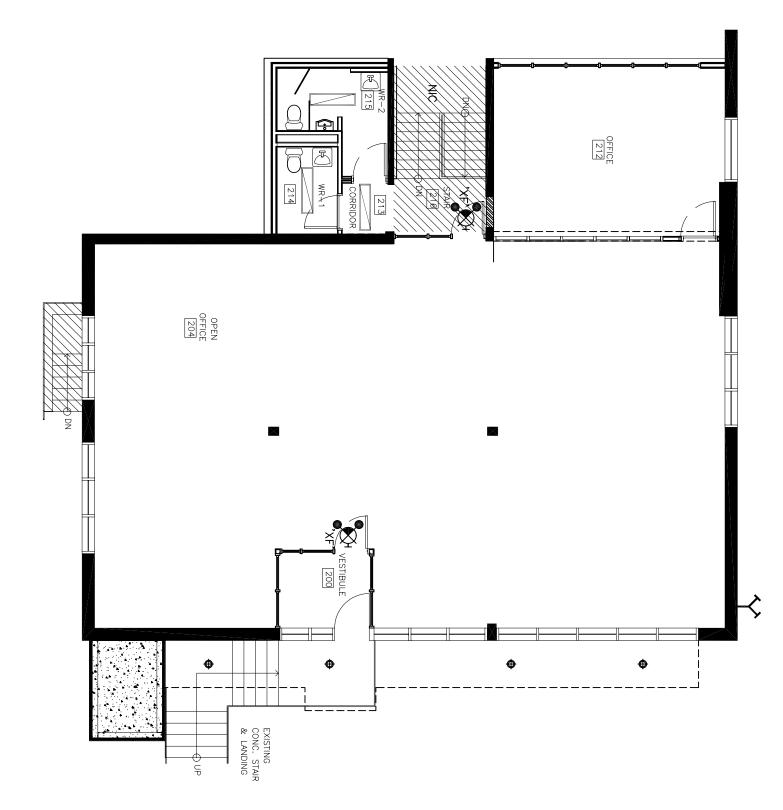

 $\frac{\text{EXIT}/\text{EMERGENCY LIGHTING}}{\text{PLAN }^2}$ LAYOUT

	SYMBOL	
SUSPENDED [CONFIF TO FURTHER DETAIL 120V		INTERIOR
SUSPENDED [CONFIRM] LIGHT FIXTURE TO FURTHER DETAIL 120V	DESCRIPTION	FIXTURE
FIXTURE	Z	INTERIOR FIXTURE SCHEDULE
	LAMPS	

36W 120V AC, 12V DC	36W 120V AC, 12V DC EMERGENCY LIGHTING BATTERY UNIT C/W TWO EMERGENCY HEADS 72W 120V AC, 12V DC, NEW
	DC, NEW

# <u>GENERAL</u>

.\_\_\_\_


- ŝ 2. SUPPLY AND INSTALL ALL ITEMS, INCLUDE ALL LABOUR, EQUIPMENT, MATERIALS, AND TOOLS NECESSARY TO COMPLETE ALL SYSTEM SHOWN ON THE DRAWINGS. ARRANGE A SITE VISIT AND INSPECT ALL DRAWINGS. NO ALLOWANCE SHALL BE MADE FOR FAILURE TO DO SO. PROVIDE ALL CUTTING & PATCHING REQUIRED FOR THE WORK OF THIS TRADE. UPON COMPLETION OF THE WORK, PROVIDE THE FINAL UNCONDITIONAL CERTIFICATE OF ACCEPTANCE FROM ONTARIO HYDRO INSPECTION DEFARTING. CLEAN UP ALL DEBRIS ON A DAILY BASIS AND UPON COMPLETION OF CONTRACT. COOPERATE WITH ALL OTHER TRADES. ALL WORK SHALL BE IN ACCORDANCE WITH THE LATEST EDITION OF THE ELECTRICAL CODE. THE RULES & BYLANS OF ALL ANTHORNIES. HANING JURSDICTION. ALL MATERIAL AND EQUIPMENT TO BE NEW, CSA APPROVED, AND BE OF COMMERCIAL GRADE. SUBMIT ONE COPY OF SHOP DRAWINGS FOR APPROVAL OF ALL PROVIDE TEMPORARY ELECTRICAL POWER FOR THE WORK OF THE TRADES AS REQUIRED BY THE GENERAL CONTRACTOR. PROVIDE LAMACOID LABELS ON ALL ELECTRICAL EQUIPMENT MOUNTED AND CONNECTED. CIRCUIT DIRECTORES FOR PANELEBOARDS TO BE TYPEWRITTEN. SUBMIT "AS BUILT" DRAWINGS WITH ONE MARKED—UP SET OF WHITE PRINTS TO THE OWNER AFTER COMPLETION OF THE OWNER. SUBMIT "AS BUILT" DRAWINGS WITH ONE MARKED—UP SET OF WHITE PRINTS TO THE OWNER AFTER COMPLETION OF WORK. ALL WRING TO BE COPPERE RW90 OR T90 INSULATION UNLESS NOTED AND #10 AWG FROM 71FT (21.6m) T0 120FT (35.6m). INSTALL ALL WRING CONCEALED IN CONDUIT, BX CABLE MAY BE USED IN INDEPENDENTLY. SUPPORTED FROM CELLING SYSTEM.
  - 4. <sup>10</sup>
  - 6.
  - 7.


œ

9.

- 11 10.


- 1 12 12 15. 14. 13. 12.

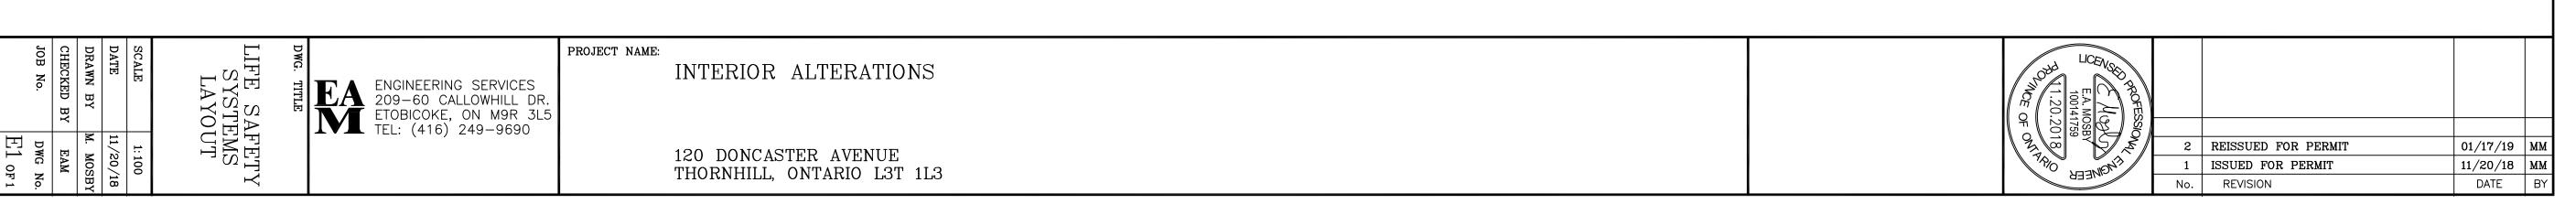

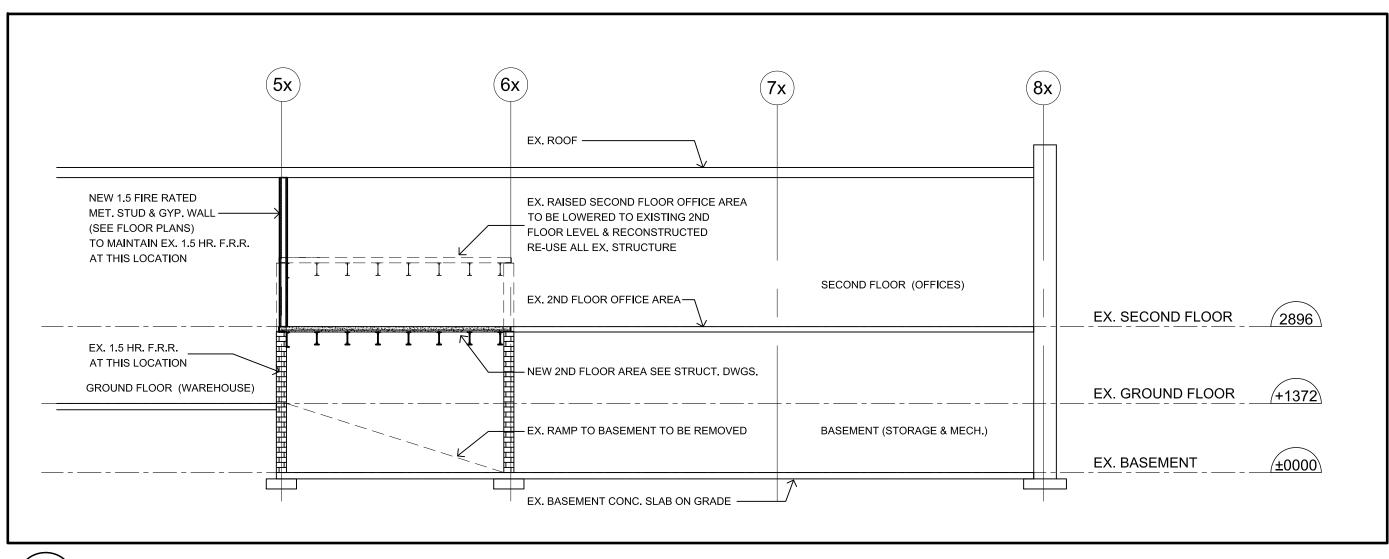

A2.1 SCALE 1:75

\_\_\_\_

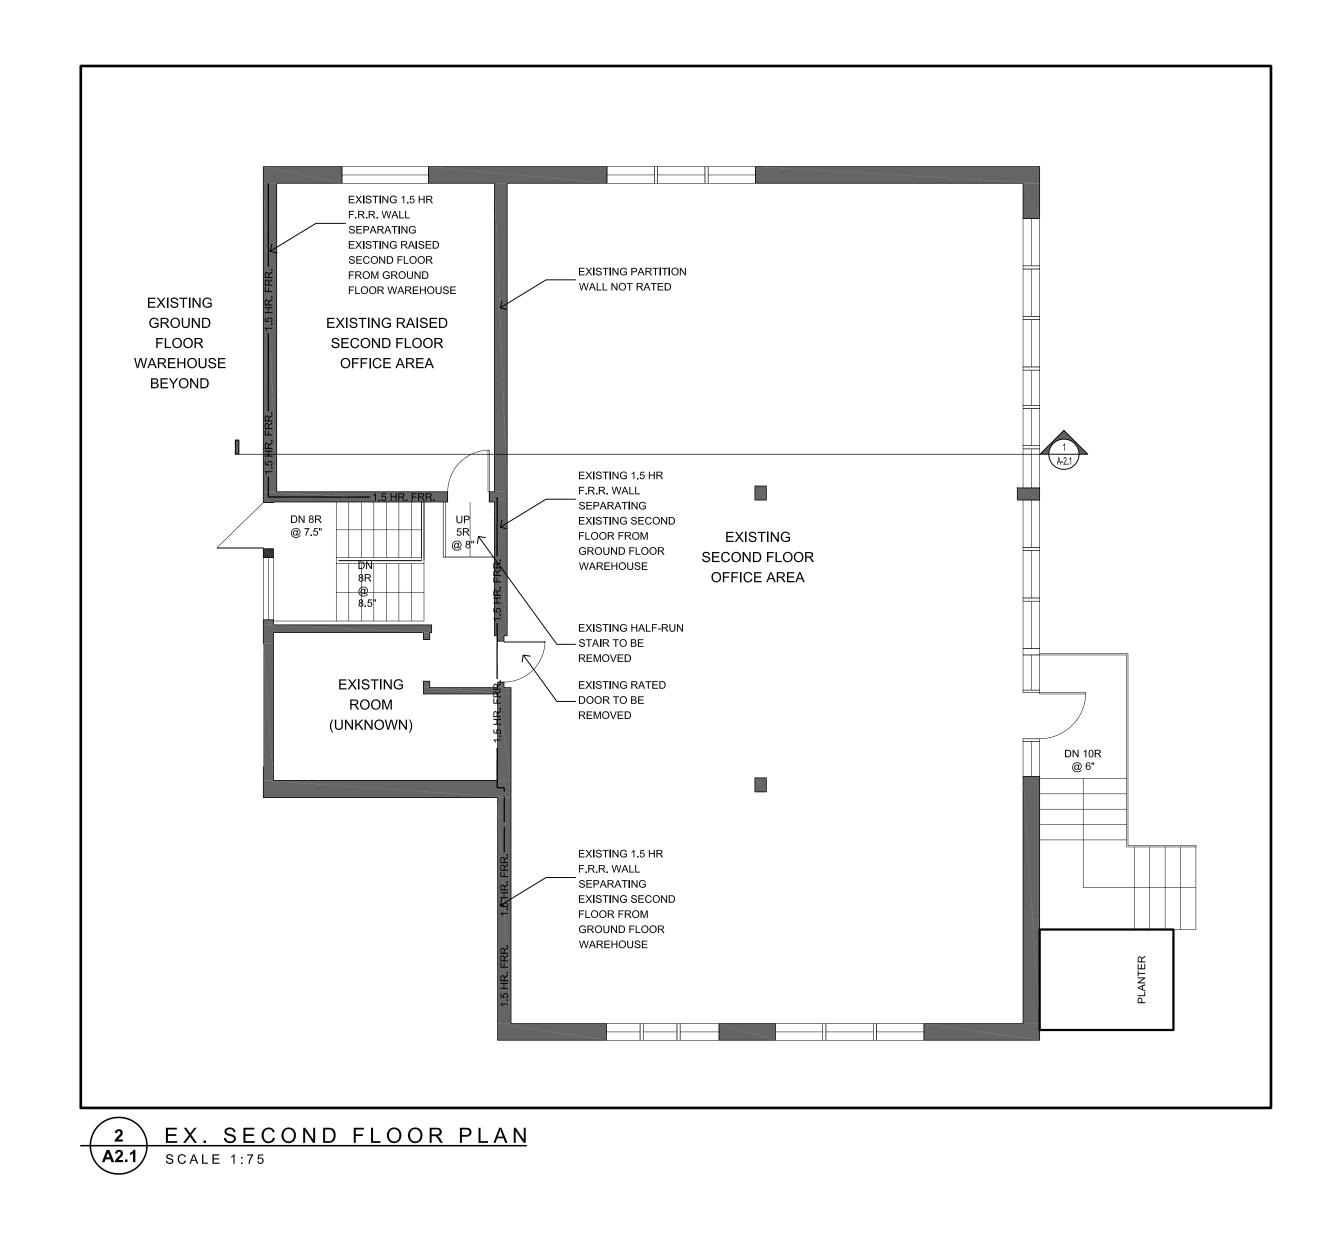

Job.

Upon Request.

Do Not Scale The Drawings.

5	OF	05

INTERIOR ALTERATIONS		
120 doncaster avenue		
AS NOTED Scale		
F.A. Checked by		
File No. File No.		
2018-12-11 Plot Date		
	A-2.1	
05 OF 05	/ <b>\</b> ⁻∠.	

#### Project DNS

### Drawing Title BUILDING SECTION & EXISTING SECOND FLR. PLAN

Inc. 27 ROYTEC, UNIT 2A WOODBRIDGE, ONTARIO, L4L 8E3 P: (905) 856-2840 F: (905) 856-4912 info@alaimoarchitecture.com www.alaimoarchitecture.com

## alaimo architecture

03 Building Permit Amendment 02 Building Permit 01 Building Permit No Issued For

Dec. 11, 2018 Nov. 23, 2018 Nov. 13, 2018 Date

FRANCESCO ALAIMO LICENCE 5837 SUILDING KEENI

NOTE: GENERAL CONTRACTOR MUST VERIFY ALL DIMENSIONS ON SITE PRIOR TO ANY WORK. IT IS THE CONTRACTORS RESPONSIBILITY TO CO-ORDINATE THE WORK OF ALL TRADES AND BRING TO THE ATTENTION OF THE ARCHITECT & ENGINEERS ANY DISCREPANCIES, DEVIATIONS, ETC. AS SOON AS THEY ARE DISCOVERED.

Reproduction Of Drawings, Specifications And Related Documents In Part Or Whole Is Forbidden Without The Architects Written Permission. This Drawing Is Not To Be Used For Construction Until Signed By The Architect. Date No Revision

Contractor Must Check And Verify All Dimensions On The

All Drawings, Specifications And Related Documents Are The Copyright Of The Architect And Must Be Returned